


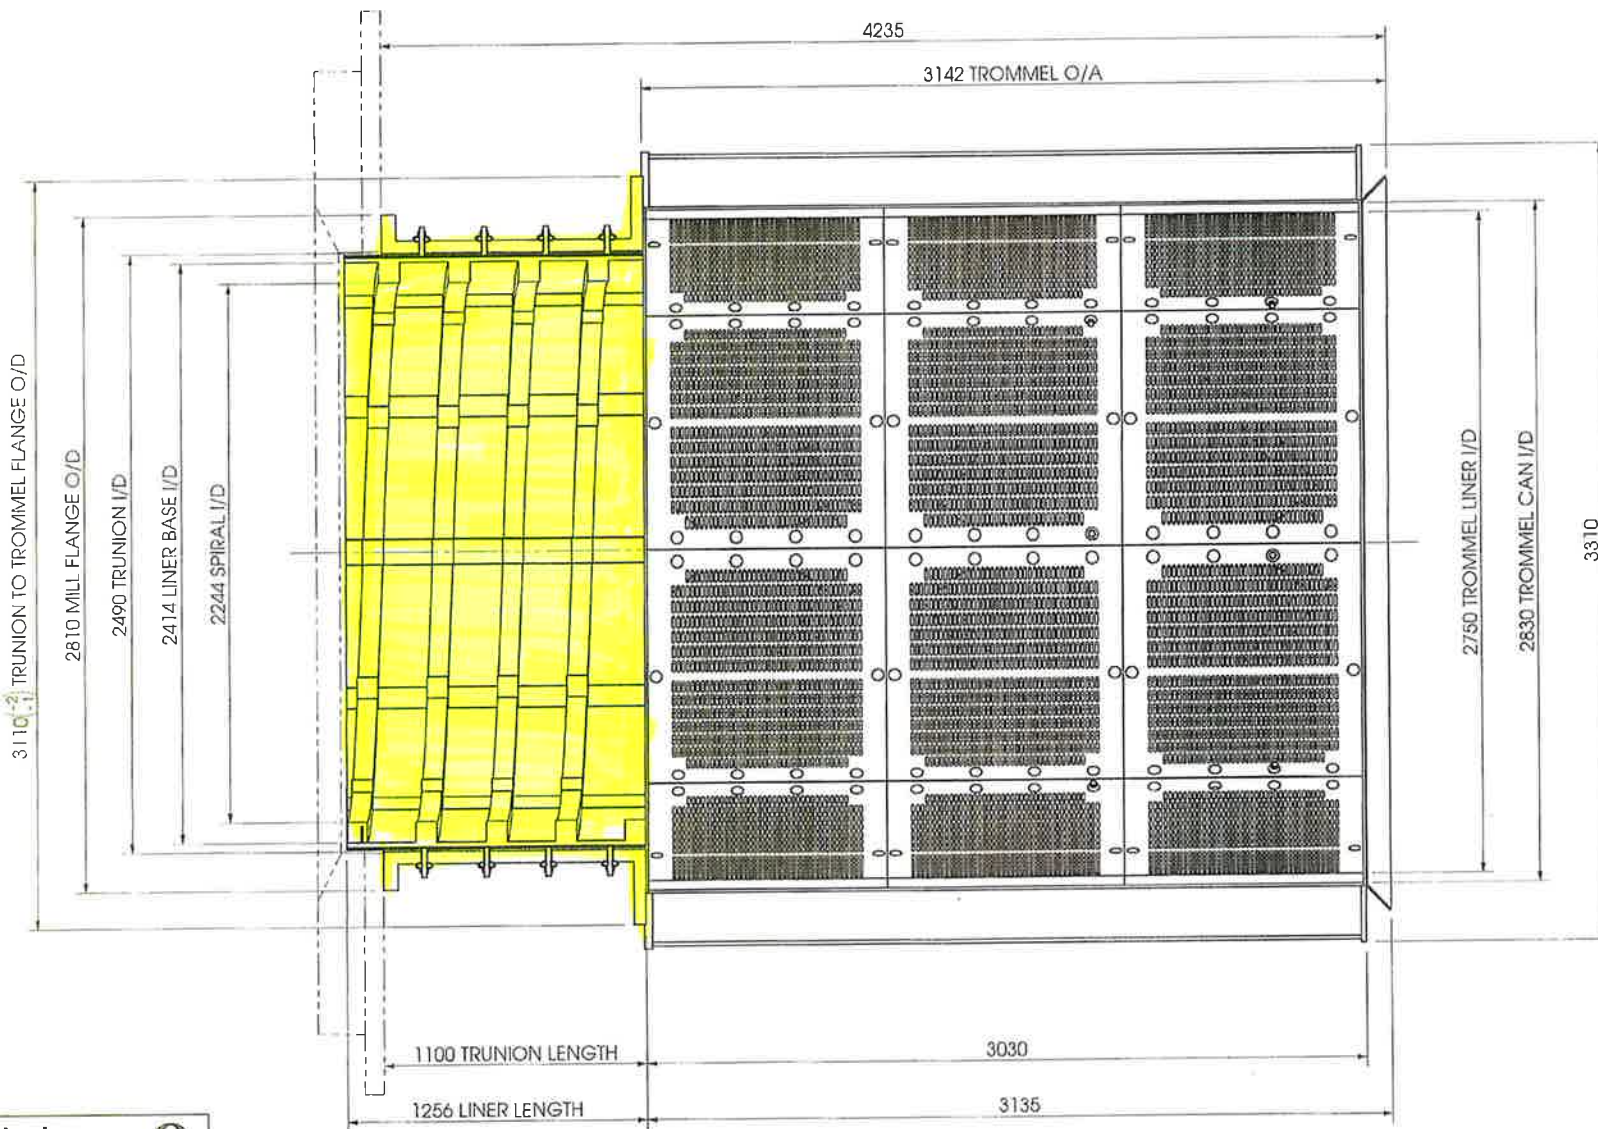

REV.	DESCRIPTION	DATE	APPROVED
A	ISSUED FOR REVIEW	19/07/2008	
	REVISION HISTORY		

TORNADO AUSTRALIA
TROMMEL PANELS

ABN: 260 976 268 49
Unit 2, 26 Biscayne Way, Jandakot, WA 6164
Phone: + 61 8 9414 7922
Fax: + 61 8 9414 7933

www.losugen.com



THIRD ANGLE PROJECTION	DATE	ALL DIMENSIONS ARE IN MILLIMETERS
QUADRO DESIGN	19-07-08	
CHECKED	DATE	
APPROVED	DATE	
QUADRO DESIGN JOB No	08783	SCALE WAS 1:20

CONSIDERED AND COUNTERSIGNED	DATE	PROJECT
		KARAMIN IRON ORE
		TROMMEL PROPOSAL
		TRUNION-TROMMEL ASSEMBLY
		08783-000
		2 of 2
		A A3


KARARA


Project No: 201012-00091
PO No: 01 PVE-PMEO17
PDT Contractors Drawing No: 1306-DW-PMEO17-1004 (Rev 0)

Review Code:

- ☐ 1 No comment. Manufacturing may proceed. Submit 'Certified Final' or 'As-Built' document.
- ☐ 2 Amend as Noted. Manufacturing may proceed subject to incorporating the changes. Resubmit revised document.
- ☐ 3 Amend as Noted and resubmit revised documents. Manufacturing shall NOT proceed.
- ☒ 4 Review complete. 'Certified Final' or 'As-Built' documents. No further resubmission.
- ☐ 5 Holdover. Reserved for Information Only.

Signed: [Signature] Date: 17/8/08
Package Engineer

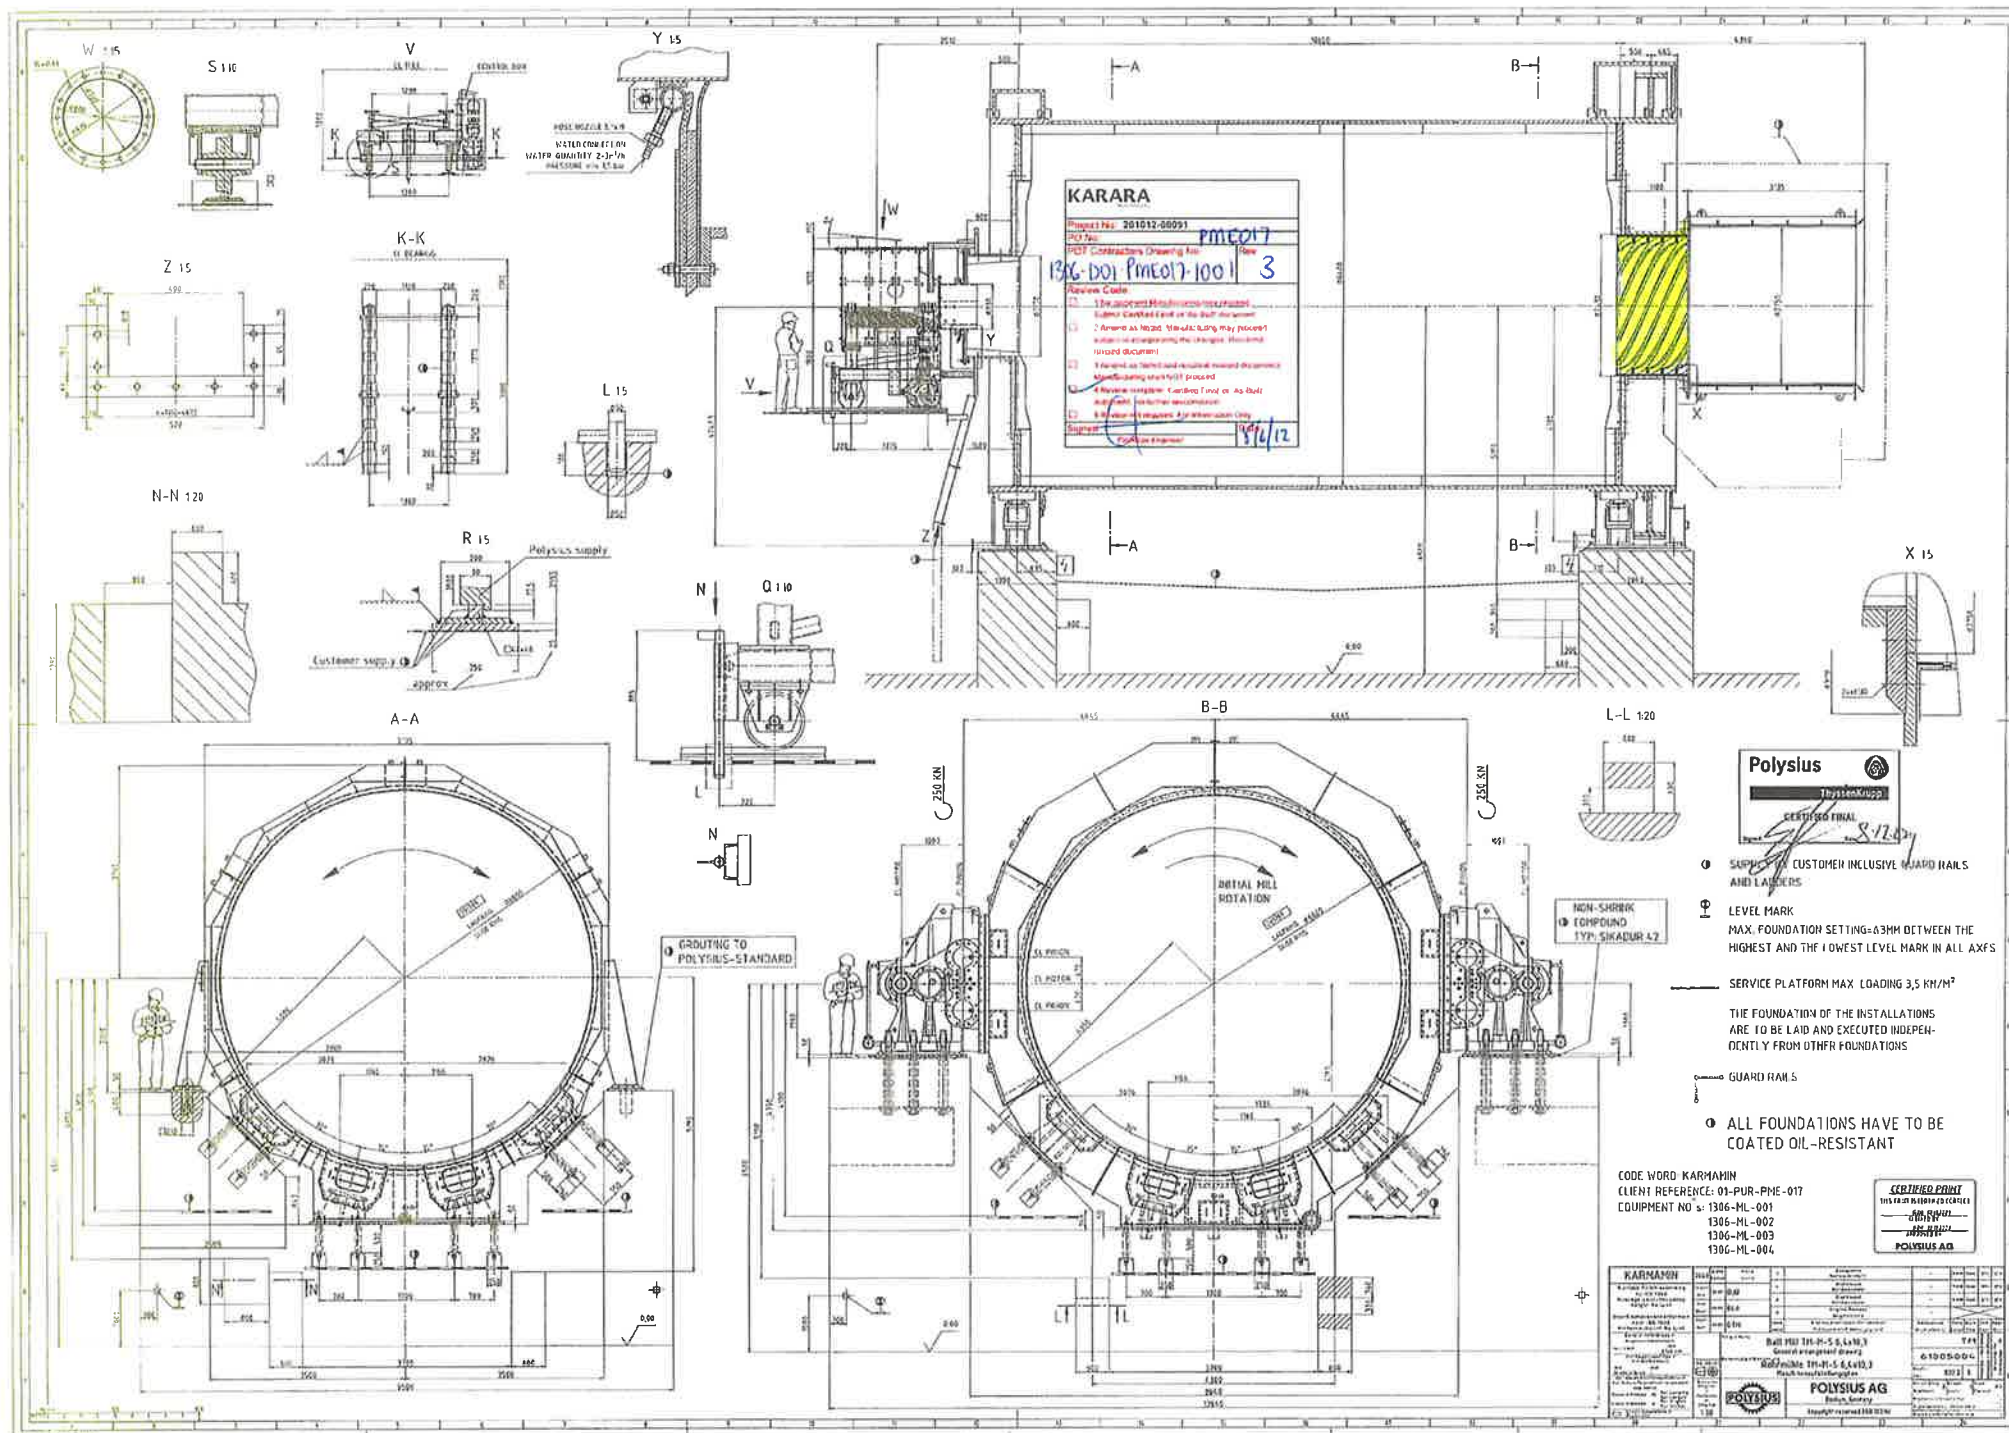

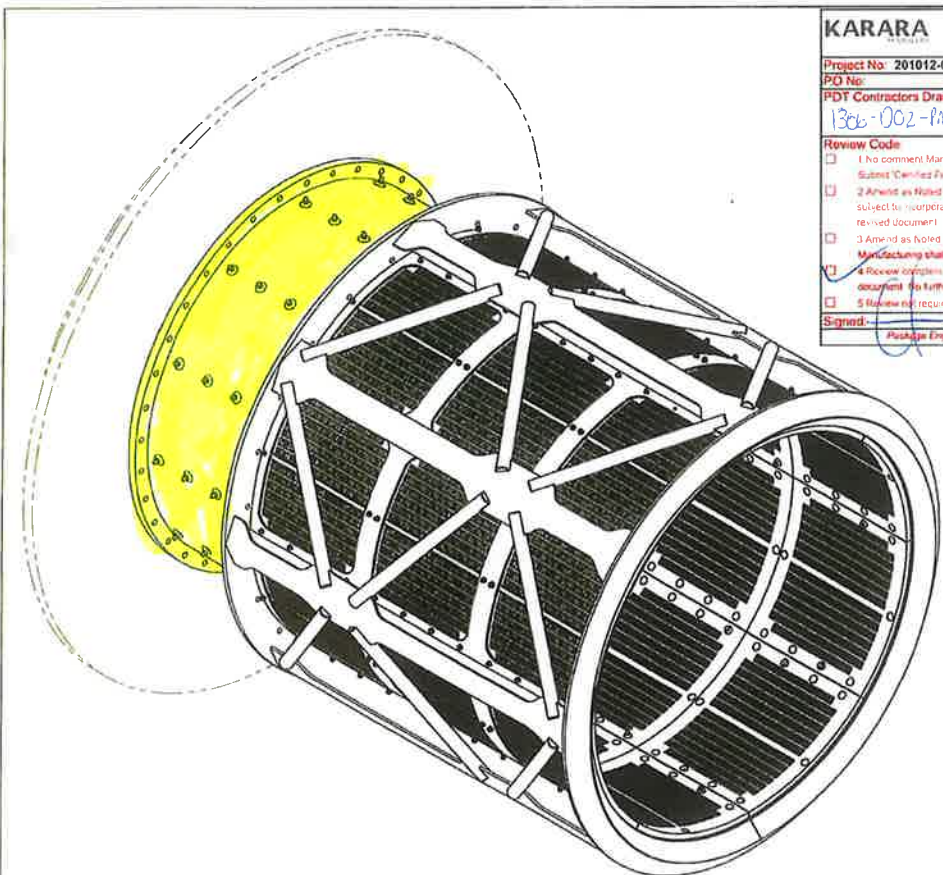

KARARA

Project No: 201012-00091

PO No:

PDT Contractors Drawing No: 1306-002-PME017-1003 Rev 1


Review Code

- ☐ 1. No comment. Manufacturing may proceed. Submit 'Certified Final' or 'As Built' document.
- ☐ 2. Amend as noted. Manufacturing may proceed subject to incorporating the changes. Resubmit revised document.
- ☐ 3. Amend as noted and re-submit revised documents. Manufacturing shall NOT proceed.
- ☒ 4. Review complete. 'Certified Final' or 'As Built' document for further resubmission.
- ☐ 5. Review not required. For Information Only.

Signed: [Signature] Date: 10/4

Project Engineer

ITEM NO.	QTY	DRAWING / PART No.	DESCRIPTION	MATERIAL	kg/ea
1	1	08783-001	TROMMEL PROPOSAL-12X20 SLOTS	SEE BOM	4458.2
2	1	08783-008	OUTLET CYLINDER ASSEMBLY	SEE BOM	6758.1

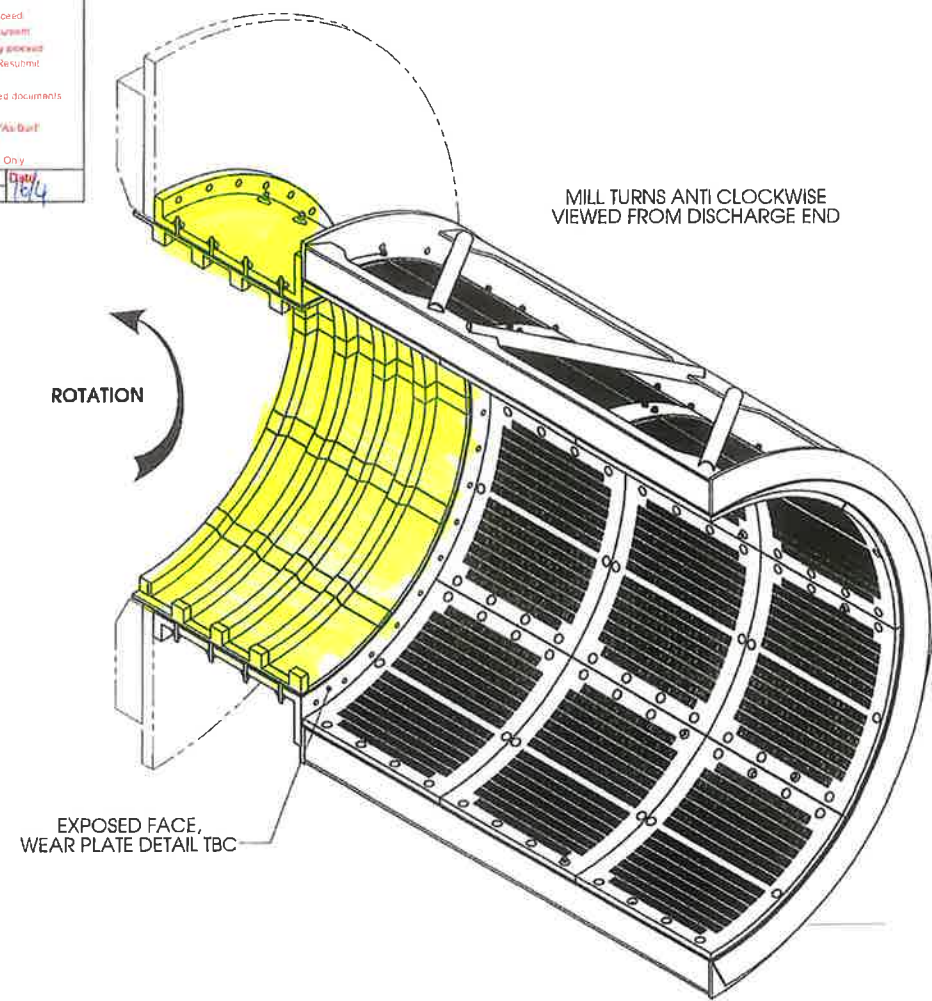

Polysius

ThyssenKrupp

CERTIFIED FINAL

Signed: [Signature] Date: 10/4

A	REV	ISSUED FOR REVIEW DESCRIPTION	19/07/2008 DATE	APPROVED

TORNADO

TROMMEL PANELS

ABN: 260 976 268 49

Unit 2, 26 Blisway Way, Jandakot, WA 6164

Phone: + 61 8 9414 7922

Fax: + 61 8 9414 7933

www.losugen.com

Losugen

Australia

THIRD ANGLE PROJECTION

DRAWN BY: QUADRO DESIGN DATE: 19-07-08

CHECKED BY: DATE:

APPROVED BY: DATE:

QUADRO DESIGN JOB No: 08783 SCALE: 1:30

ALL DIMENSIONS ARE IN MILLIMETERS

Copyright and Copying: This drawing and the design and technical information shown is the exclusive property of Losugen Pty Ltd and/or its associate. The information must only be used on the project condition listed, except with our written permission. It must not be reproduced, copied or communicated to any third party not entitled to use for any other purpose than the particular condition or assembly to which it is related and/or is to be used.

PROJECT: KARAMIN IRON ORE TROMMEL PROPOSAL TRUNION-TROMMEL ASSEMBLY

DRAWING No: 08783-000

SHEET 1 OF 2 REV A